




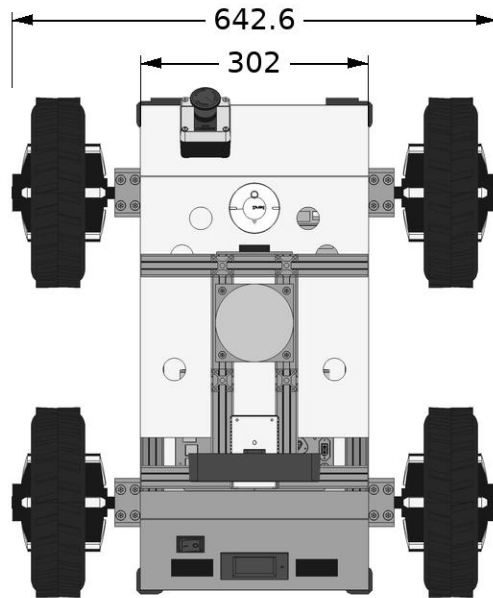


TOP

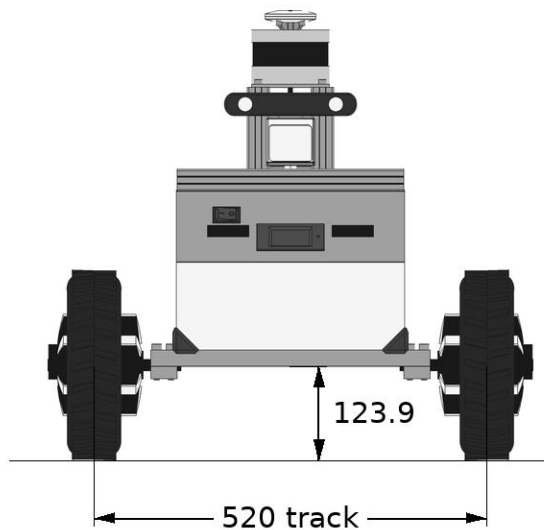

FRONT

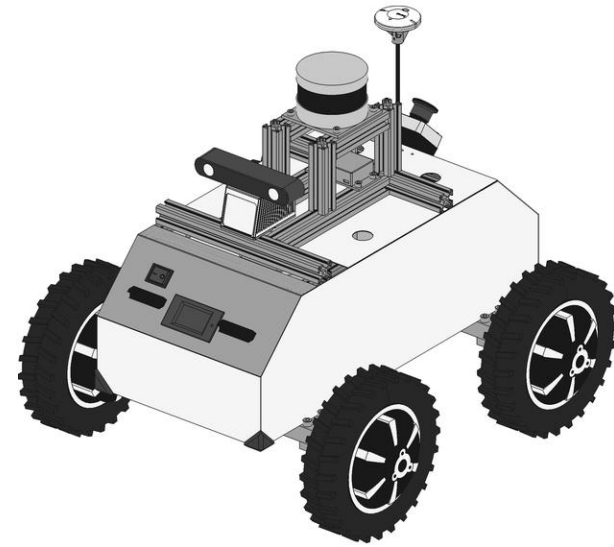

ISOMETRIC

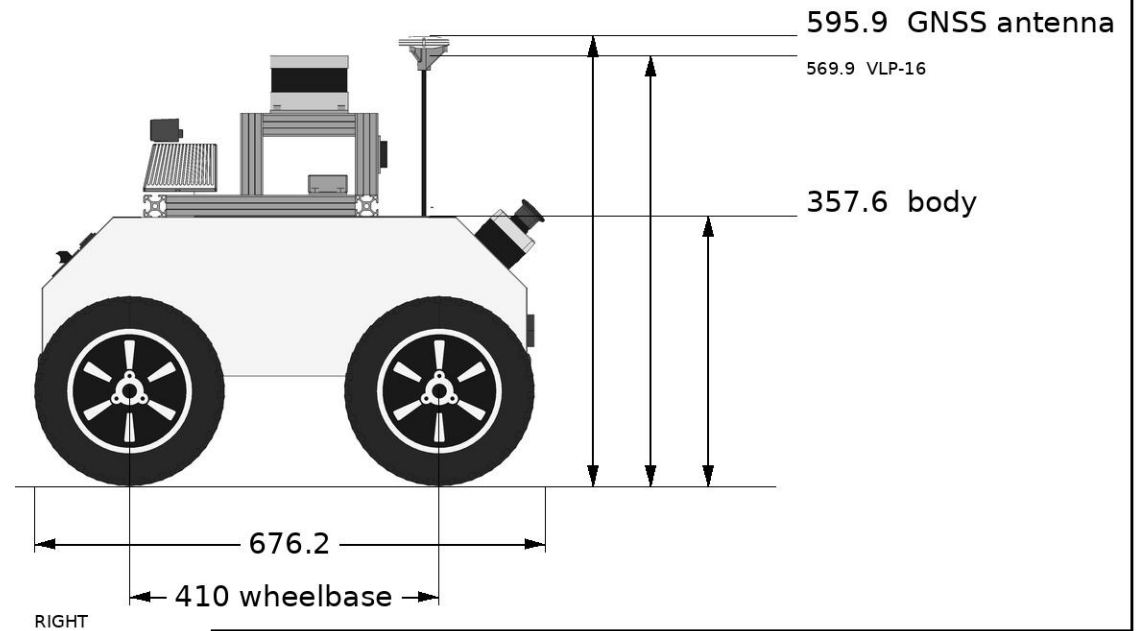

RIGHT

SMUB 4×4 — GENERAL ARRANGEMENT

DIMENSIONS IN MM
THIRD ANGLE PROJECTION
GROUND AT Z = 0

AS-BUILT CONFIGURATION
VLP-16 · MID-70 · ZED 2i
HERE2 GNSS · AHRS X1

BAUNURI
SCALE 1:10 (A, LANDSCAPE)
REV 2026-10-14 SHEET 1/1